


### WINDOWS SCHEDULE & NOTES

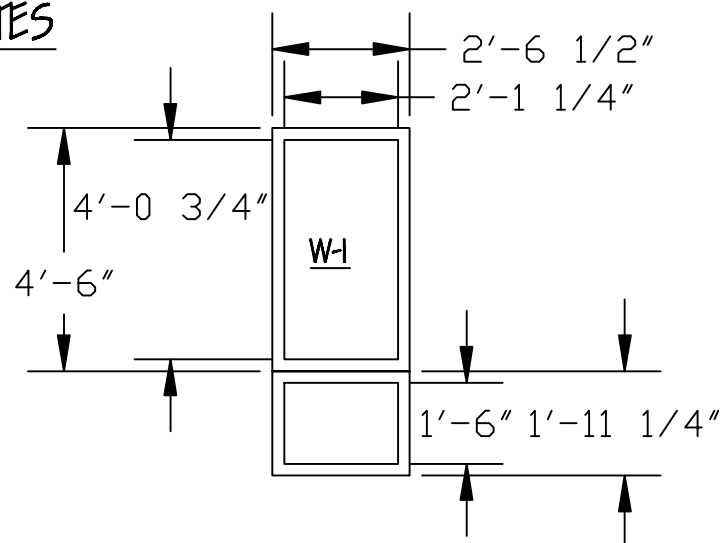

#### WINDOW SCHEDULE AND NOTES:

- A) W-1 #2 X LEFT HAND OPENING CASEMENT OVER TEMPERED FIXED.
- B) W-1 #2 X RIGHT HAND OPENING CASEMENT OVER TEMPERED FIXED.
- C) W-1 #2 X FIXED OVER TEMPERED FIXED.
- D) W-1 SHGC-GLASS = 0.68; U-GLASS = 0.21.
- E) W-2 #6 X CASEMENT, NOMINAL 2' WIDE X 3' HIGH GLASS, OR SIMILAR WITH SUFFICIENT CLEAR SPAN TO MEET CODE FOR EMERGENCY EGRESS.
- F) W-2 U-GLASS = 0.12.
- G) W-3 #1 X MINIMUM HEIGHT GLASS (15-3/4") X 3' WIDE AWNING.
- H) W-3 U<0.22
- I) FRONT DOOR #1 X 36" WIDE X 6'-10" HIGH EXTERIOR DIMENSIONS, \*\*\*ALL TEMPERED GLASS\*\*\* WITH SAME CHARACTERISTICS AS W-1.
- J) ALL WINDOWS TO BE EXTRUDED FIBERGLASS FRAMES.
- K) ALL WINDOWS TO INCLUDE SCREENS.
- L) W-1 TO HAVE FOLDING HANDLES.
- M) REAR DOORS TO BE INSULATED FIBERGLASS WITH 24" X 24" DOUBLE GLAZED WINDOW.
- N) INTERIOR HINGED SHUTTERS OF 1" FOIL COVERED POLYISO FOAM TO BE FITTED TO SOUTH WINDOWS.

### MONTAGUE URBAN HOMESTEAD

OWNERS/ DESIGNERS: DOUGLAS A. STEPHENS

TINA CLARKE

BUILDER:

BICK CORSA

AS-BUILT:

1-21-2010

SCALE:

1" = 4'

SHEET 4 OF 4

