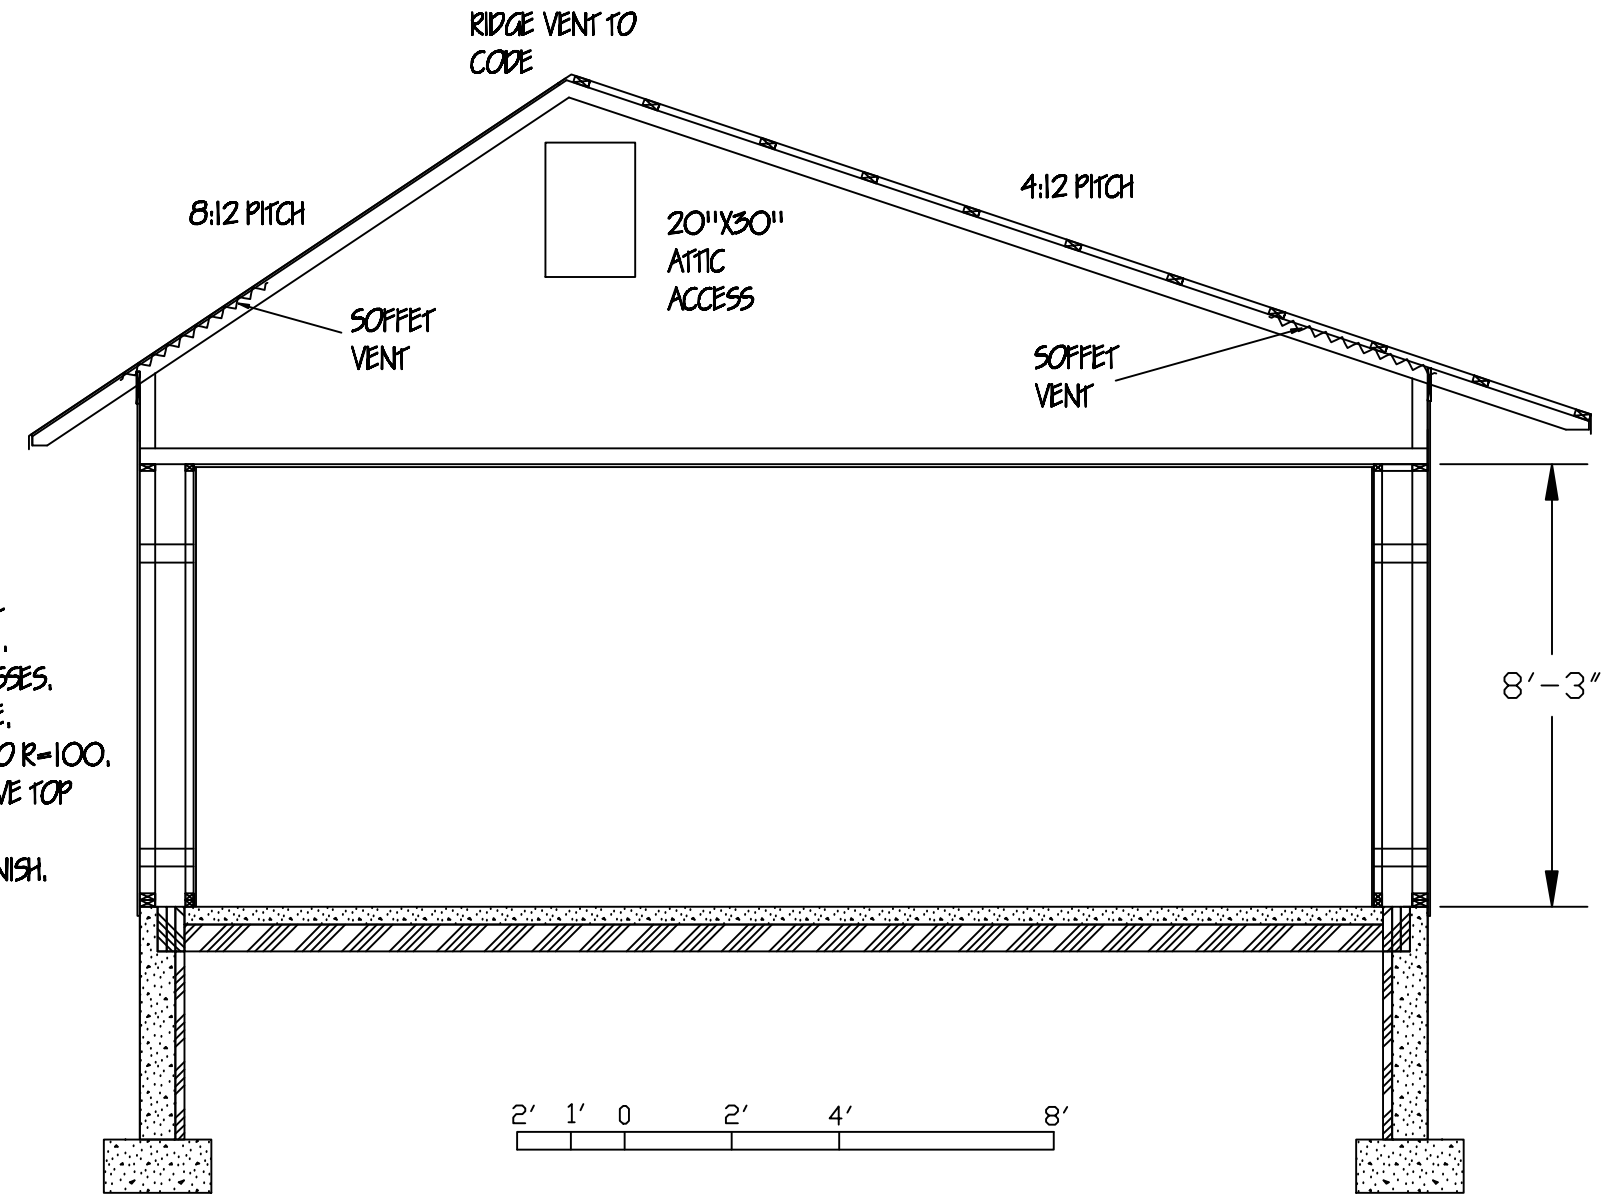

ROOF SECTION

STANDING SEAM METAL ROOF.
ON $\frac{1}{2}$" CDX (south) or HORIZONTAL
2X4 STRAPPING @ 24 O.C. (north).
PRE-FABRICATED ENGINEERED TRUSSES.
ANGLED CROSS BRACING TO CODE.
LOOSE FILL BLOWN CELLULOSE TO R-100.
SOFFET VENTS TO EXTEND 1' ABOVE TOP
OF LOOSE FILL INSULATION.
1/2" GYPSUM BOARD INTERIOR FINISH.

WALL SECTION

FSC CEDAR SHINGLES WITH FILTERED BOILED LINSEED OIL TREATMENT.
TYVEK HOUSE WRAP WITH ALL SEAMS TAPED.
ON 1/2" CDX PLYWOOD SHEATHING, ALL SEAMS AND PENETRATIONS CAULKED.
2"X4" STUDS/FRAMING @ 24"O.C..
4"X12" PLYWOOD TRUSSES CONNECTING EXTERIOR WALL
TO 2"X2" INTERIOR WALL FRAMING CREATING A TOTAL WALL WIDTH OF 12".
12" DENSE PACKED BLOWN CELLULOSE (R-45).
1/2" GYPSUM BOARD INTERIOR FINISH.
WALLS PAINTED WITH LOW PERMEABILITY
VAPOR DIFFUSION RETARDING PAINT OF LESS THAN 1 PERM.
2"X4" SILLS ARE PRESSURE TREATED.
ON A CLOSED-CELL FOAM SILL SEALER.
OVER A COPPER TERMITE FLASHING
1/2" ANCHOR BOLTS AT 48" MAX SPACING, 12" MIN. FROM ALL CORNERS

MONTAGUE URBAN HOMESTEAD

OWNERS/DESIGNER:	DOUGLAS A. STEPHENS
	TINA CLARKE
BUILDER:	BICK CORSA
AS-BUILT:	1-21-2010
SCALE:	1"=4'
SHEET 3 OF 4	